


THIS DRAWING IS UNPUBLISHED. RELEASED FOR PUBLICATION  
 © COPYRIGHT 19 BY AMP INCORPORATED, HARRISBURG, PA. ALL INTERNATIONAL RIGHTS RESERVED. AMP PRODUCTS MAY BE COVERED BY U.S. AND FOREIGN PATENTS AND/OR PATENTS PENDING.

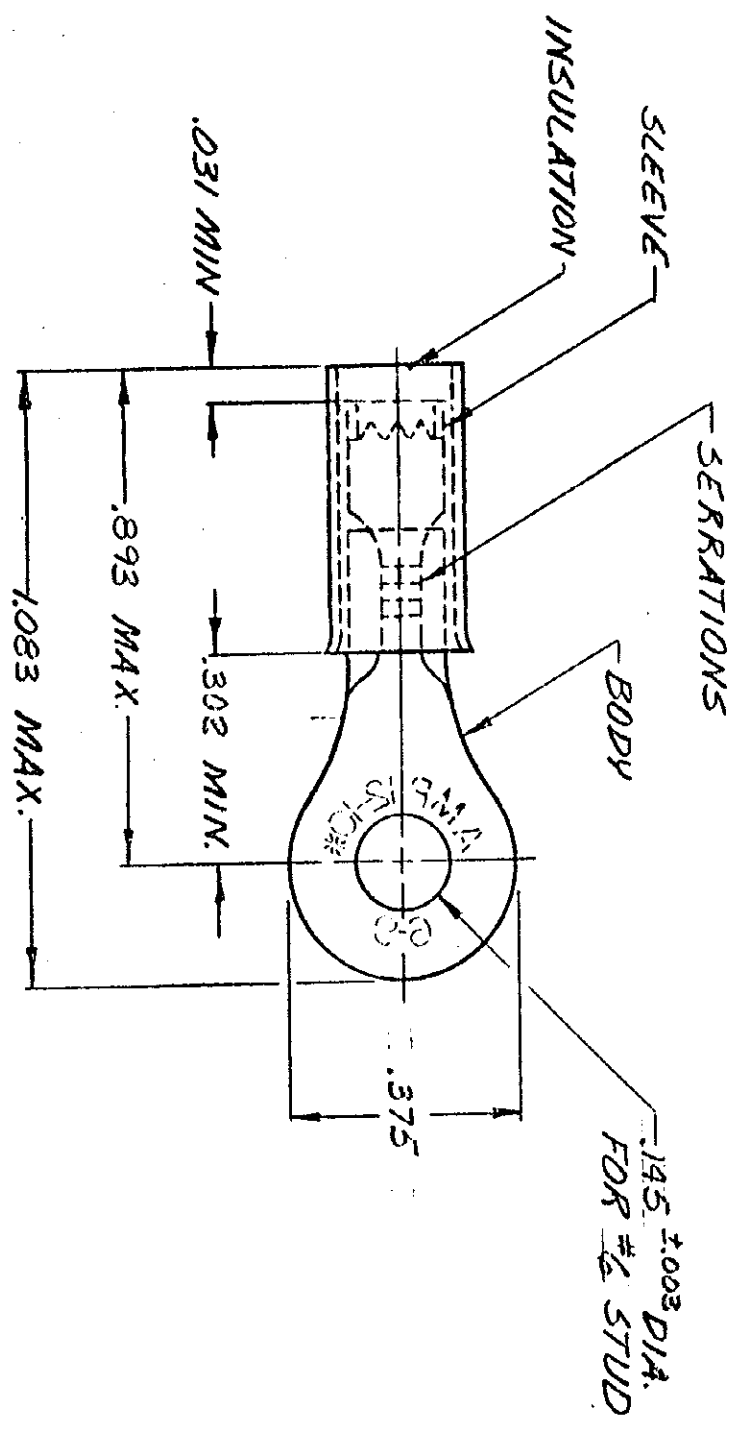

- 1 FOR .150 TO .230 WIRE INSULATION DIA.
- 2 TONGUE MATERIAL THK-.040 ±.002

REVISIONS		DESCRIPTION	DATE	APPROVED
P	F	RED UN # ADD 2-3 P85-0291	10/30/85	PMF
V	F	OBSOLETE 2--3 PER G-2393	1/24/85	200
V	G	REV/0720-0360-93	3-31-85	70/mrl

OBSOLETE

QTY	PACKAGE TYPE	PART NO.
—	LOOSE PIECE	320567
2,500	ON TAPE, REEL	2-320567-2
<del>500</del>	<del>ON TAPE, REEL</del>	<del>2-320567-3</del>
50	LOOSE PC, BOX	8-320567-2

UNLESS OTHERWISE SPECIFIED DIMENSIONS ARE IN INCHES ON DECIMALS ±.008 ANGLES	CONTRACT NO	DR <i>P. Farley</i> 10/30/85	CHK <i>J. ...</i> 11/6/85	NAME	AMP	AMP INCORPORATED Harrisburg, Pa.
MATERIAL	SEE TABLE	APPD <i>M. ...</i> 11/6/85	APPD	TERMINAL, RIDG, RING, 12-10		
FINISH	SEE TABLE	DSGN APPD	OTHER APPD	SIZE	B	FSCM NO 00779
				DRAWING NO		320567
				SCALE	NTS	SHEET

BODY & SLEEVE:  
 COPPER QQ-C-576  
 TIN PL MIL-T-10727  
 INSULATION:  
 NYLON MIL-M-20693  
 COLOR: YELLOW