


DRAWING MADE IN AMERICAN PROJECTION

LOC 6 SHEET 14

© 1970 BY AMP INCORPORATED. ALL RIGHTS RESERVED. AMP PRODUCTS COVERED BY PATENTS AND/OR PATENTS PENDING.

REVISIONS			
LTR	DESCRIPTION	DATE	APPROVED
D	<del>REV PER G-571</del>	2/1/88	<i>[Signature]</i>
E	REV PER G-571	2/24/90	OKS/PSG
C	331366 OBSOLETE G-2340	DAP 4/10/87	<i>[Signature]</i>

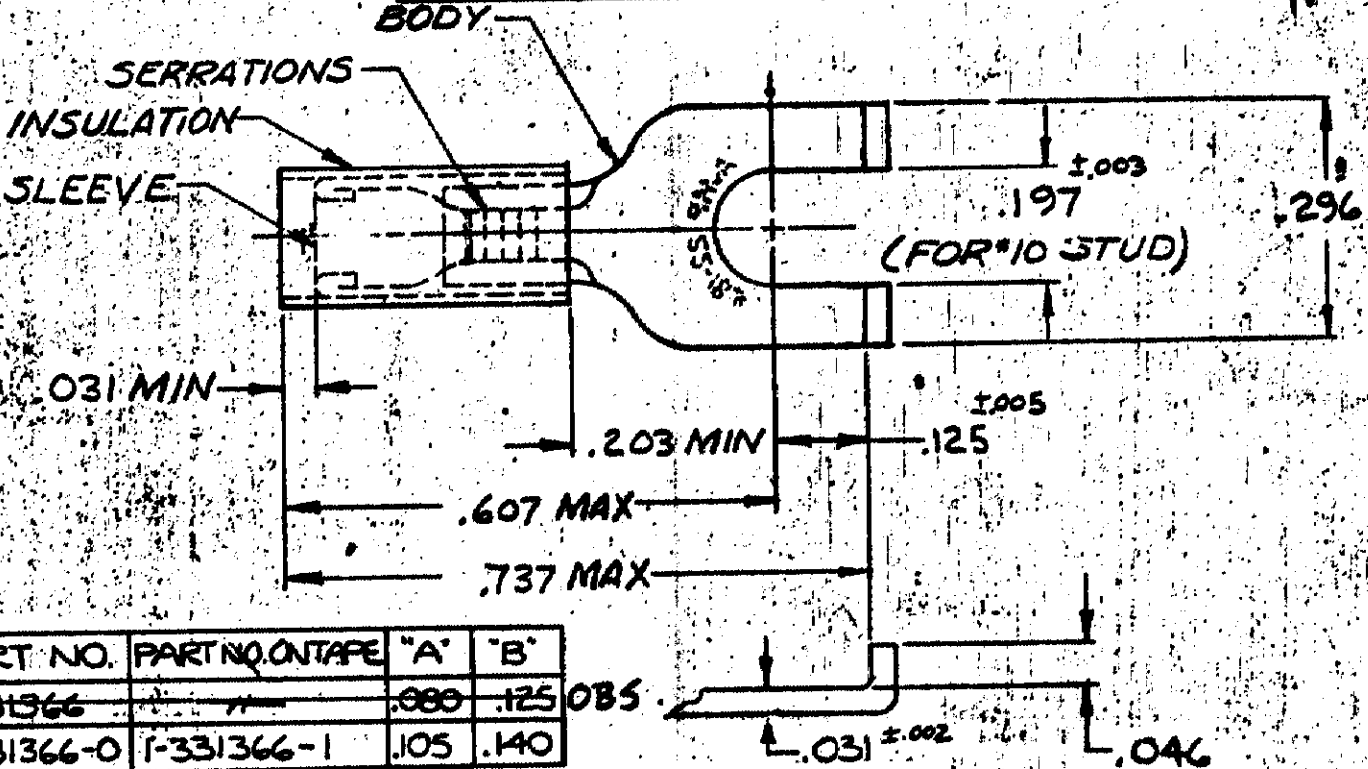

PART NO.	PART NO. ON TAPE	"A"	"B"
331366		.080	.125 OBS
1-331366-0	1-331366-1	.105	.140

FOR "A" TO "B" WIRE INS. DIA.  
MARKING 22-18 FOR MILITARY  
COMMERCIAL RANGE 22-16

1-331366-0 ON TAPE	1-331366-1	SLEEVE: COPPER (QQ-C-576)
WIRE	1-331366-0	BODY: COPPER (QQ-C-576)
Terminal	<del>331366</del> OBSOLETE	TIN PL (MIL-T-10727)
QTY DESCRIPTION PART NO		INSULATION: NYLON
		COLOR: RED
		MATERIAL & FINISH
UNLESS OTHERWISE SPECIFIED DIMENSIONS ARE IN INCHES. TOLERANCES ON: DECIMALS ±.008 ANGLES ±5°		 AMP INCORPORATED HARRISBURG, PENNSYLVANIA
CONTRACT NO. _____		
DR. <i>[Signature]</i> 8-14-70		NAME WIRE TERMINAL
CHK. <i>[Signature]</i> 8-17-70		
APPD. <i>[Signature]</i> 8-17-70		P.I.D.G. - FLANGED SPADE WIRE SIZE: 22-16
REL. <i>[Signature]</i> 8-17-70		
DSGN APPD		SIZE A
OTHER APPD		CODE IDENT NO. 00779
SEE TABLE		NUMBER 331366
		SCALE NTS
		SHEET 1 OF 1